


FIRST FLOOR PLAN 1/4
PACE RESIDENCE
AS-BUILTS
 1233 ROTHSAY CIRCLE
 RICHMOND, VA. 23221
 02.25.2008

LOWER LEVEL GROSS
SQUARE FOOTAGE
3097 SQUARE FEET

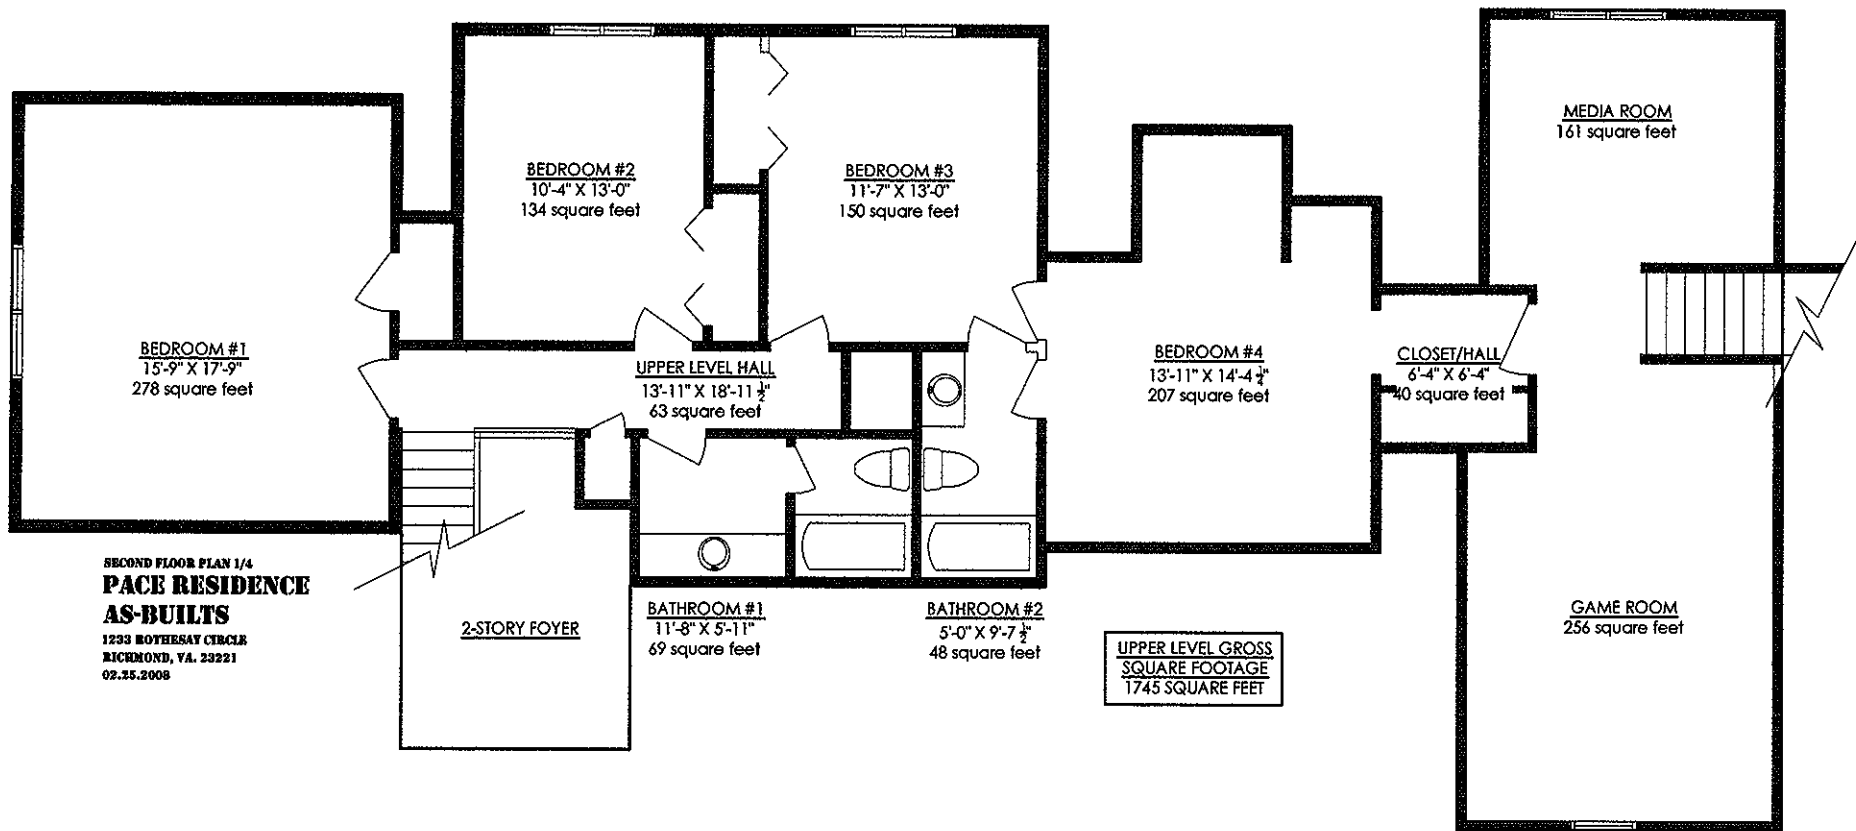

SECOND FLOOR PLAN 1/4
PACE RESIDENCE
AS-BUILTS
 1233 BOTHERSAY CIRCLE
 RICHMOND, VA. 23221
 02.25.2008